
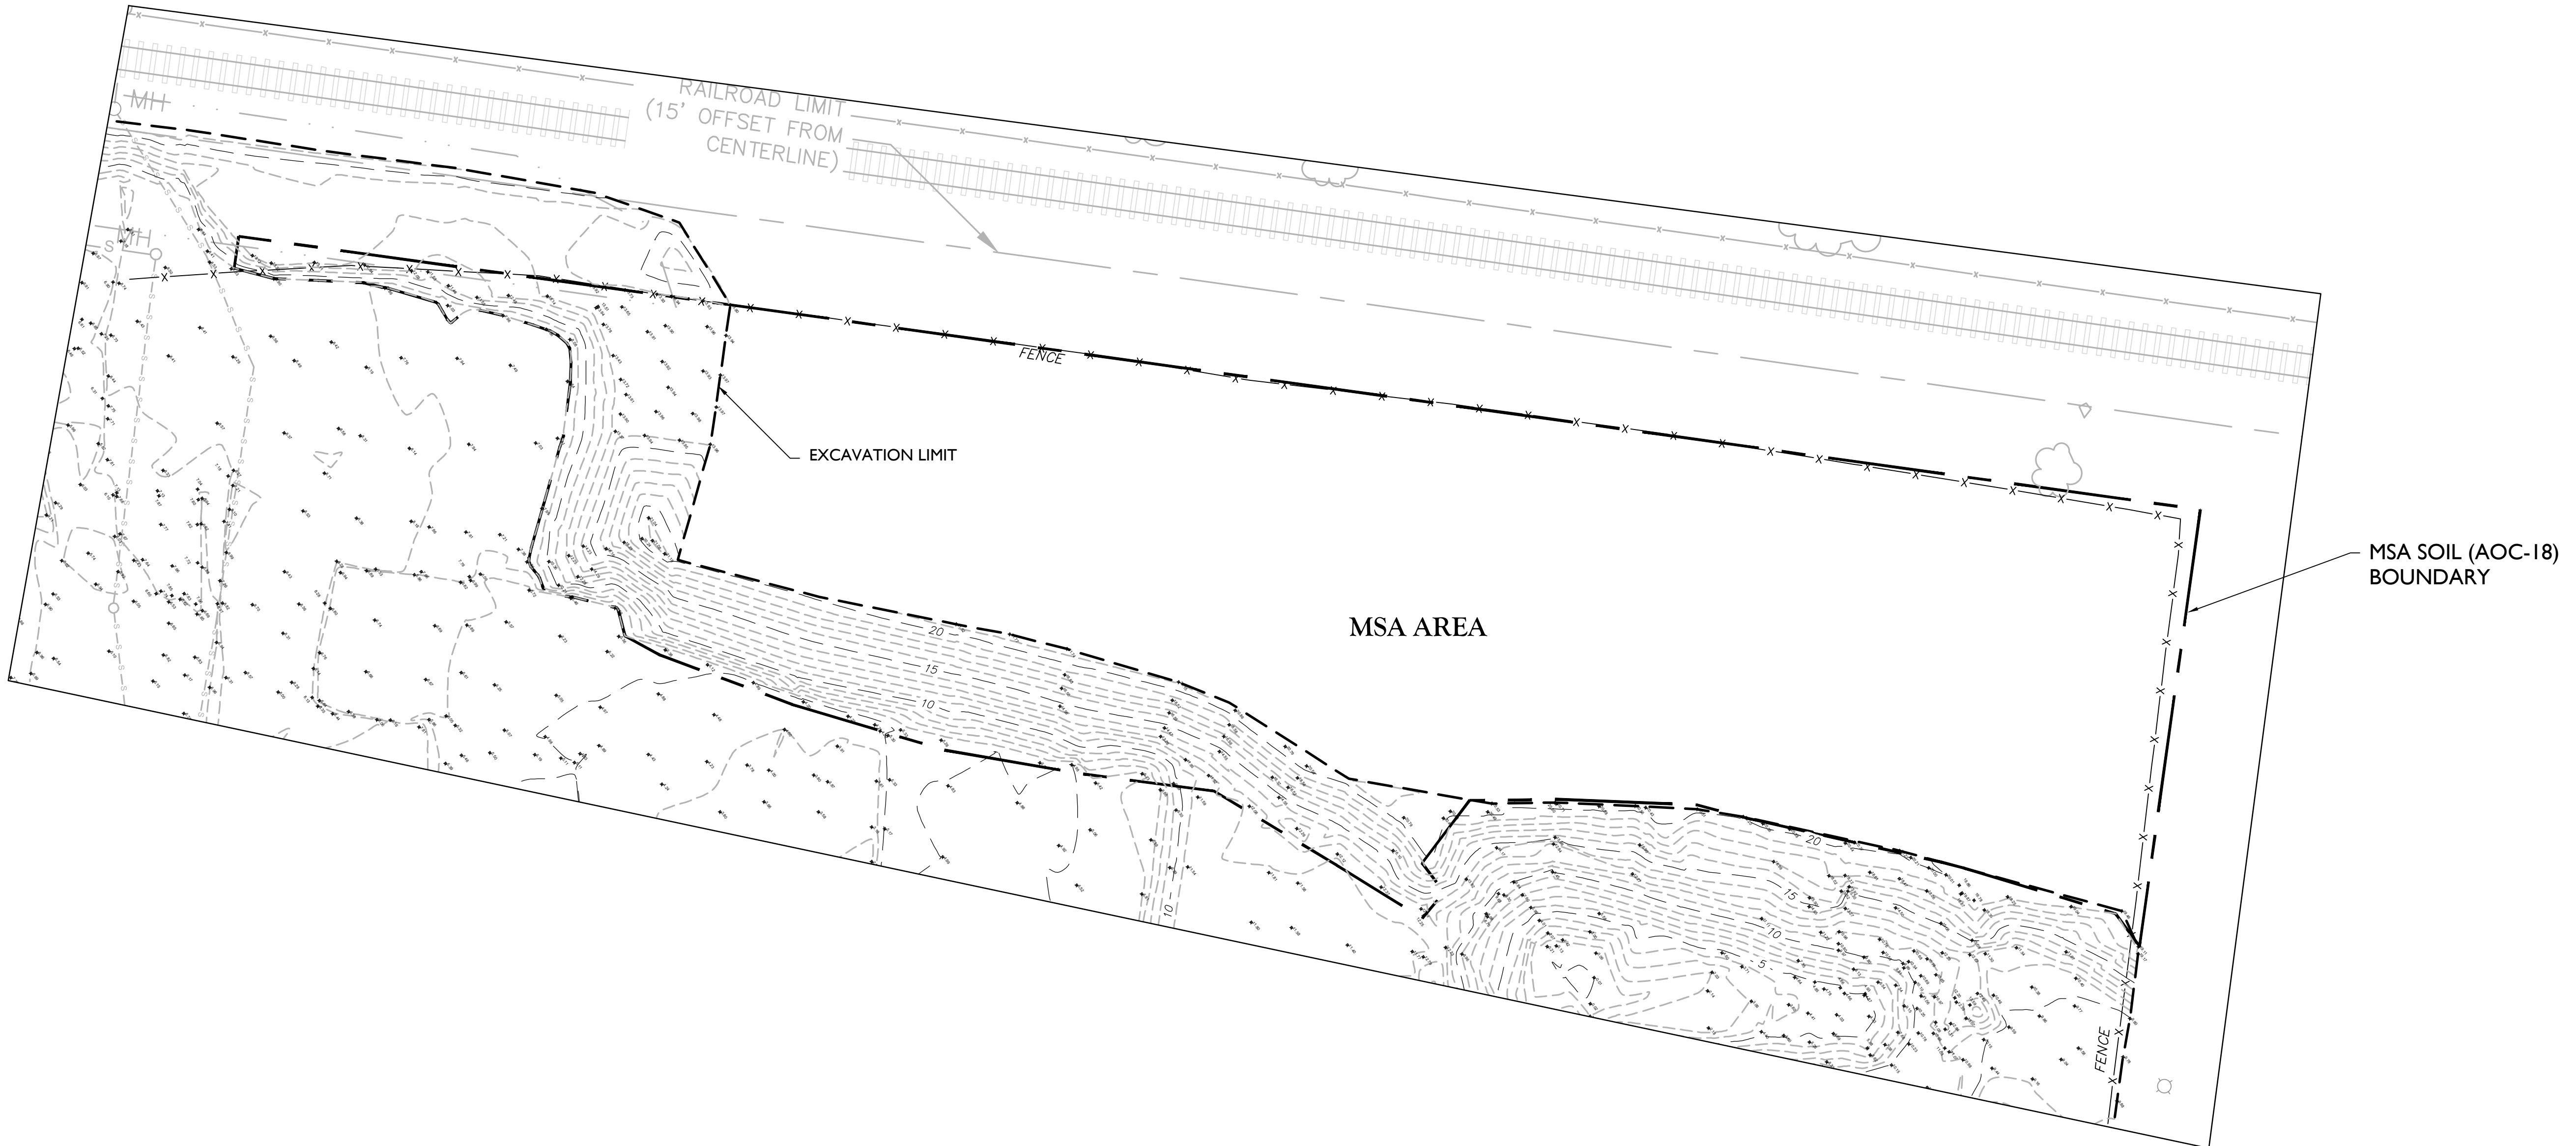


# Appendix F

## As-Built Diagrams

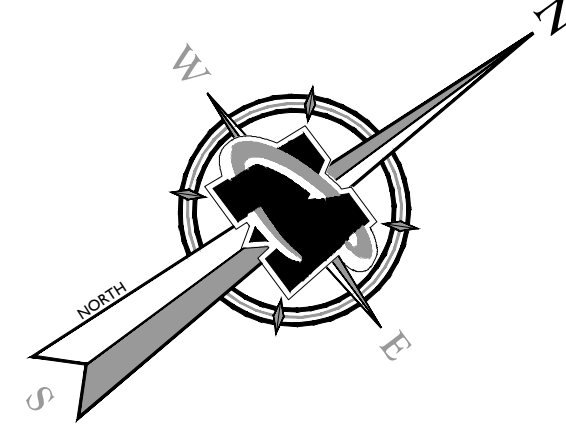

**811**  
 Know what's below.  
 Call before you dig.  
 FOR STATE SPECIFIC DIRECT PHONE NUMBERS VISIT:  
 WWW.CALL811.COM

REV	DATE	DRAWN BY	DESCRIPTION

REV	DATE	DRAWN BY	DESCRIPTION
1	7/25/21	DMS	GENERAL REVISIONS PER ARCADIS REQUEST 7/15/21

**R. THOMAS HUGG**  
 NEW JERSEY PROFESSIONAL  
 LAND SURVEYOR - LICENSE NUMBER: G536737

**POST EXCAVATION SURVEY**  
 FOR  
**ENTACT, LLC**

MSA AREA  
 PPG SITE 107  
 FASHIONLAND  
 18 CHAPEL AVENUE

JERSEY CITY  
 HUDSON COUNTY  
 NEW JERSEY

**EGG HARBOR OFFICE**  
 500 Scarborough Drive,  
 Suite 108  
 Egg Harbor, NJ 08234  
 Phone: 609.390.1927  
 Fax: 609.390.0040

SCALE	DATE	DRAWN BY	CHECKED BY
AS SHOWN	3/14/21	DMS	RTM
PROJECT NUMBER	DRAWING NAME		
17007872A	V-POST-EX		

SHEET TITLE:  
**POST EXCAVATION SURVEY**

SHEET NUMBER:  
**01 of 01**

**GENERAL NOTES**

1. THE SOLE PURPOSE OF THIS PLAN IS TO SHOW POST EXCAVATION CONDITIONS & ELEVATIONS WITHIN THE MSA AREA AT THE PROJECT SITE.
2. MSA AREA POST EXCAVATION LOCATIONS AND ELEVATIONS WERE OBTAINED BY MASER CONSULTING P.A. & ENTACT, LLC, BETWEEN 6/18/18 & 9/27/19
3. HORIZONTAL DATUM NAD 1983, VERTICAL DATUM NAVD 88.

**REFERENCES**

1. PLANS ENTITLED, "PROPOSED DEMOLITION AND EXCAVATION, PPG SITE 107, FASHIONLAND, 18 CHAPEL AVENUE, JERSEY CITY, NEW JERSEY" PREPARED BY ARCADIS U.S., INC., DATED SEPTEMBER, 2017.
2. PLANS ENTITLED, "FINAL AS-BUILT SURVEY, PPG SITE 107, FASHIONLAND, 18 CHAPEL AVENUE, JERSEY CITY, HUDSON COUNTY, NEW JERSEY" PREPARED BY MASER CONSULTING, P.A., LAST REVISED 3/26/21.
3. PLANS ENTITLED, "POST EXCAVATION SURVEY, PPG SITE 107, FASHIONLAND, 18 CHAPEL AVENUE, JERSEY CITY, HUDSON COUNTY, NEW JERSEY" PREPARED BY MASER CONSULTING, P.A., LAST REVISED 3/10/21.

**LEGEND**

- 20' --- POST EXCAVATION MAJOR CONTOUR
- 10' --- POST EXCAVATION MINOR CONTOUR

