

Appendix F

As-Built Diagrams

Red Bank, NJ	Lehigh Valley, PA
Clinton, NJ	Exton, PA
Holmdel, NJ	Pittsburgh, PA
Egg Harbor, NJ	Tampa, FL
Long Branch, NJ	Orlando, FL
Mc Arlington, NJ	Montgomery, NY
Albany, NY	Sterling, VA
West Orange, NJ	Albuquerque, NM
Columbia, MD	Charlotte, NC

 Copyright © 2001 Maser Consulting P.A. All rights reserved.
 The information contained herein is authorized for use only by the party for whom it was intended. It is understood and agreed that it may not be copied, read, disclosed, distributed or relied upon for other purposes without the express written consent of Maser Consulting P.A.


GENERAL NOTES
 PPG SITE 107
 FASHIONLAND
 18 CHAPEL AVENUE
 JERSEY CITY
 HUDDSON COUNTY
 NEW JERSEY


- THE SOLE PURPOSE OF THIS PLAN IS TO SHOW POST EXCAVATION CONDITIONS & ELEVATIONS AT THE PROJECT SITE.
- POST EXCAVATION LOCATIONS AND ELEVATIONS WERE OBTAINED BY MASER CONSULTING P.A. & ENTACT, LLC. BETWEEN 6/18/18 & 9/27/19.
- HORIZONTAL DATUM NAD 1983, VERTICAL DATUM NAVD '88.

- REFERENCES
 1. PLANS ENTITLED, "PROPOSED DEMOLITION AND EXCAVATION, PPG SITE 107, FASHIONLAND, 18 CHAPEL AVENUE, JERSEY CITY, NEW JERSEY" PREPARED BY ARCADIS U.S., INC., DATED SEPTEMBER, 2017.

EGG HARBOR OFFICE
 500 Scarborough Drive,
 Suite 108
 Egg Harbor, NJ 08234
 Phone: 609.390.1927
 Fax: 609.390.0040

DATE:	08/07/18	DRAFTER:	RTH
PROJECT NUMBER:	F10097872A	DRAWING NAME:	V-POST-EX
SHEET TITLE: POST EXCAVATION SURVEY			

SCALE: 1" = 30'
 SHEET NUMBER: 01 of 01

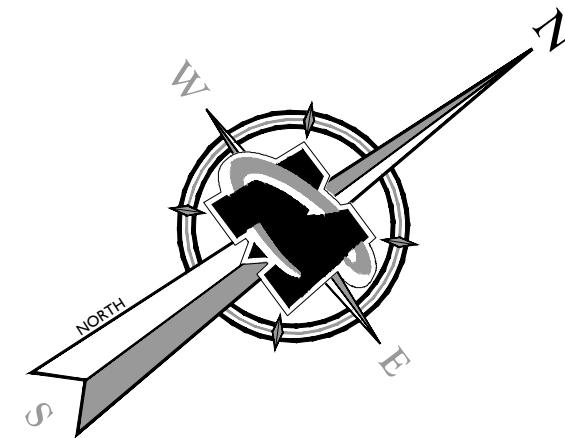

R. THOMAS HUGG
NEW JERSEY PROFESSIONAL
LAND SURVEYOR - LICENSE NUMBER: GS3673

POST EXCAVATION
SAMPLE SURVEY
FOR
ENTACT, LLC

PPG SITE 107
FASHIONLAND
18 CHAPEL AVENUE
JERSEY CITY
HUDSON COUNTY
NEW JERSEY

EGG HARBOR OFFICE
500 Scarborough Drive,
Suite 108
Egg Harbor, NJ 08224
Phone: 609.390.1927
Fax: 609.390.0040

DATE DRAWN BY CHECKED BY:
AS SHOWN 08/07/18 RTH

PROJECT NUMBER DRAWING NAME
F10007872A V-PORT-EX


SHEET TITLE:
POST EXCAVATION SAMPLE SURVEY


SHEET NUMBER:
01 of 01

SCALE: 1" = 30'


- GENERAL NOTES
- THE SOLE PURPOSE OF THIS PLAN IS TO SHOW POST EXCAVATION SAMPLE LOCATIONS & ELEVATIONS AT THE PROJECT SITE.
 - POST EXCAVATION SAMPLE LOCATIONS AND ELEVATIONS WERE OBTAINED BY MASER CONSULTING P.A. & ENTACT, LLC. BETWEEN 6/18/18 & 9/27/19.
 - HORIZONTAL DATUM NAD 1983, VERTICAL DATUM NAVD 88.

- REFERENCES
- PLANS ENTITLED, "PROPOSED DEMOLITION AND EXCAVATION, PPG SITE 107, FASHIONLAND, 18 CHAPEL AVENUE, JERSEY CITY, NEW JERSEY" PREPARED BY ARCADIS U.S., INC., DATED SEPTEMBER, 2017.

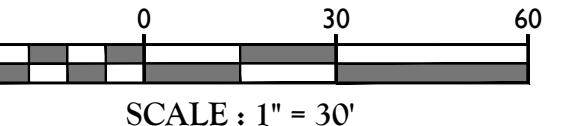

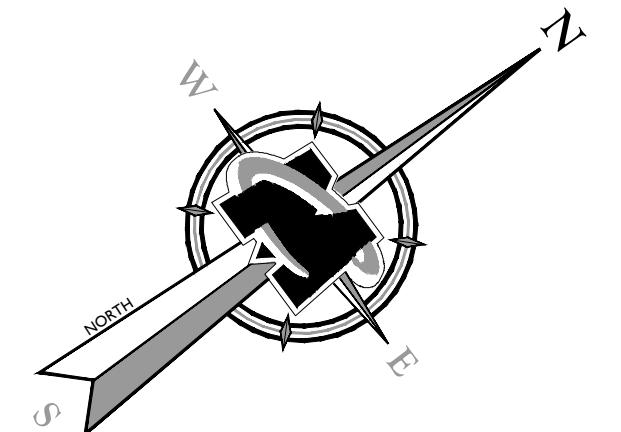
 Red Bank, NJ
 Clinton, NJ
 Hoboken, NJ
 Egg Harbor, NJ
 Mt. Arlington, NJ
 Albany, NY
 New York, NY
 Westchester County, NY
 Columbia, MD
 Lehigh Valley, PA
 Exton, PA
 Pittsburgh, PA
 Miami, FL
 Orlando, FL
 Sterling, VA
 Albuquerque, NM
 Charlotte, NC

Copyright © 2011 Maser Consulting, A High Risk Engineering Company. All rights reserved. The information contained herein is authorized for use only by the party for whom it was intended. It is the property of Maser Consulting, A High Risk Engineering Company, and may not be copied, recited, disclosed, distributed or relied upon for other purposes without the express written consent of Maser Consulting, A High Risk Engineering Company.

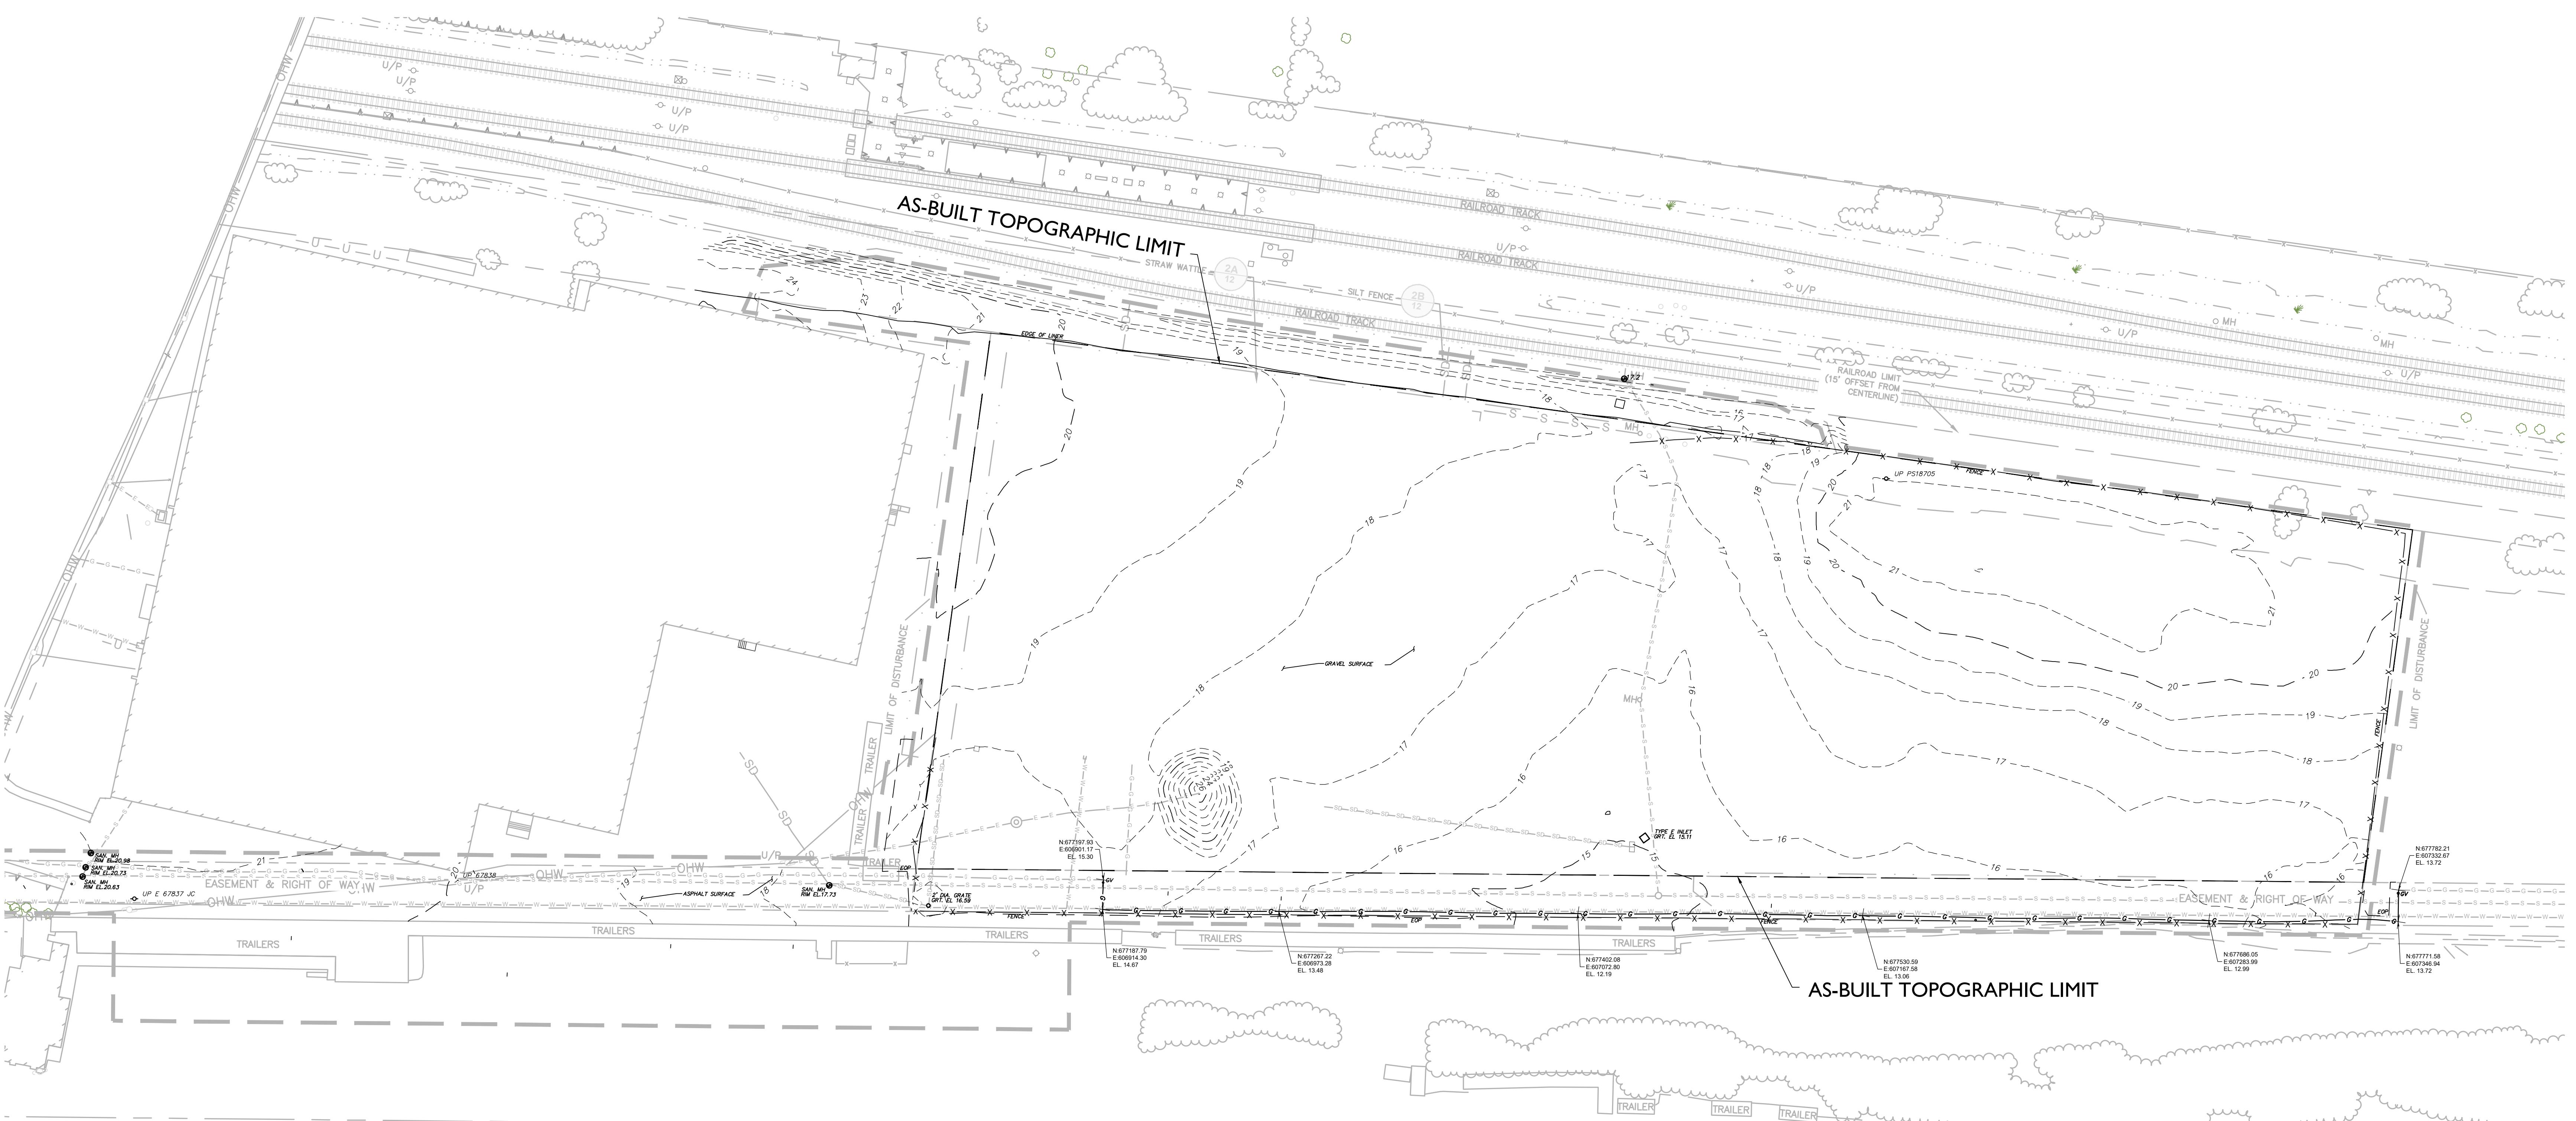 ALL TRADES CONTRACTORS
 EXCAVATORS, DESIGNERS, OR ANY PERSON
 WORKING ON A CONSTRUCTION PROJECT,
 DIAL 811
 KNOW WHAT'S BELOW.
 Call before you dig.
 FOR STATE SPECIFIC DIRECT PHONE NUMBERS VISIT:
 WWW.CALL811.COM

 R. THOMAS HUGG
 NEW JERSEY PROFESSIONAL
 LAND SURVEYOR - LICENSE NUMBER: GS36737

 FINAL AS-BUILT SURVEY
 FOR
 ENTACT, LLC

 PPG SITE 107
 FASHIONLAND
 18 CHAPEL AVENUE

 JERSEY CITY
 HUDSON COUNTY
 NEW JERSEY

 EGG HARBOR OFFICE
 500 Scarborough Drive,
 Suite 108
 Egg Harbor, NJ 08234
 Phone: 609.390.1927
 Fax: 609.390.0040

GENERAL NOTES

- THE SOLE PURPOSE OF THIS PLAN IS TO SHOW THE INTERIM AS-BUILT LOCATIONS & ELEVATIONS AT THE PROJECT SITE.
- INTERIM AS-BUILT LOCATIONS AND ELEVATIONS WERE OBTAINED BY MASER CONSULTING P.A. ON 10/19/19 & 03/10/21.
- HORIZONTAL DATUM NAD 1983, VERTICAL DATUM NAVD 88.

REFERENCES

- PLANS ENTITLED, 'PROPOSED DEMOLITION AND EXCAVATION, PPG SITE 107, FASHIONLAND, 18 CHAPEL AVENUE, JERSEY CITY, NEW JERSEY' PREPARED BY ARCADIS U.S., INC., DATED SEPTEMBER, 2017.

 40 0 40 80
SCALE : 1" = 40'

 FINAL AS-BUILT
 TOPOGRAPHIC SURVEY

SHEET NUMBER: 01 of 01

AS SHOWN	DATE	DRAFTER	CHECKED BY
PROJECT NUMBER: F10097872A	DRAWING NAME: V-FINLASBT		RTH